


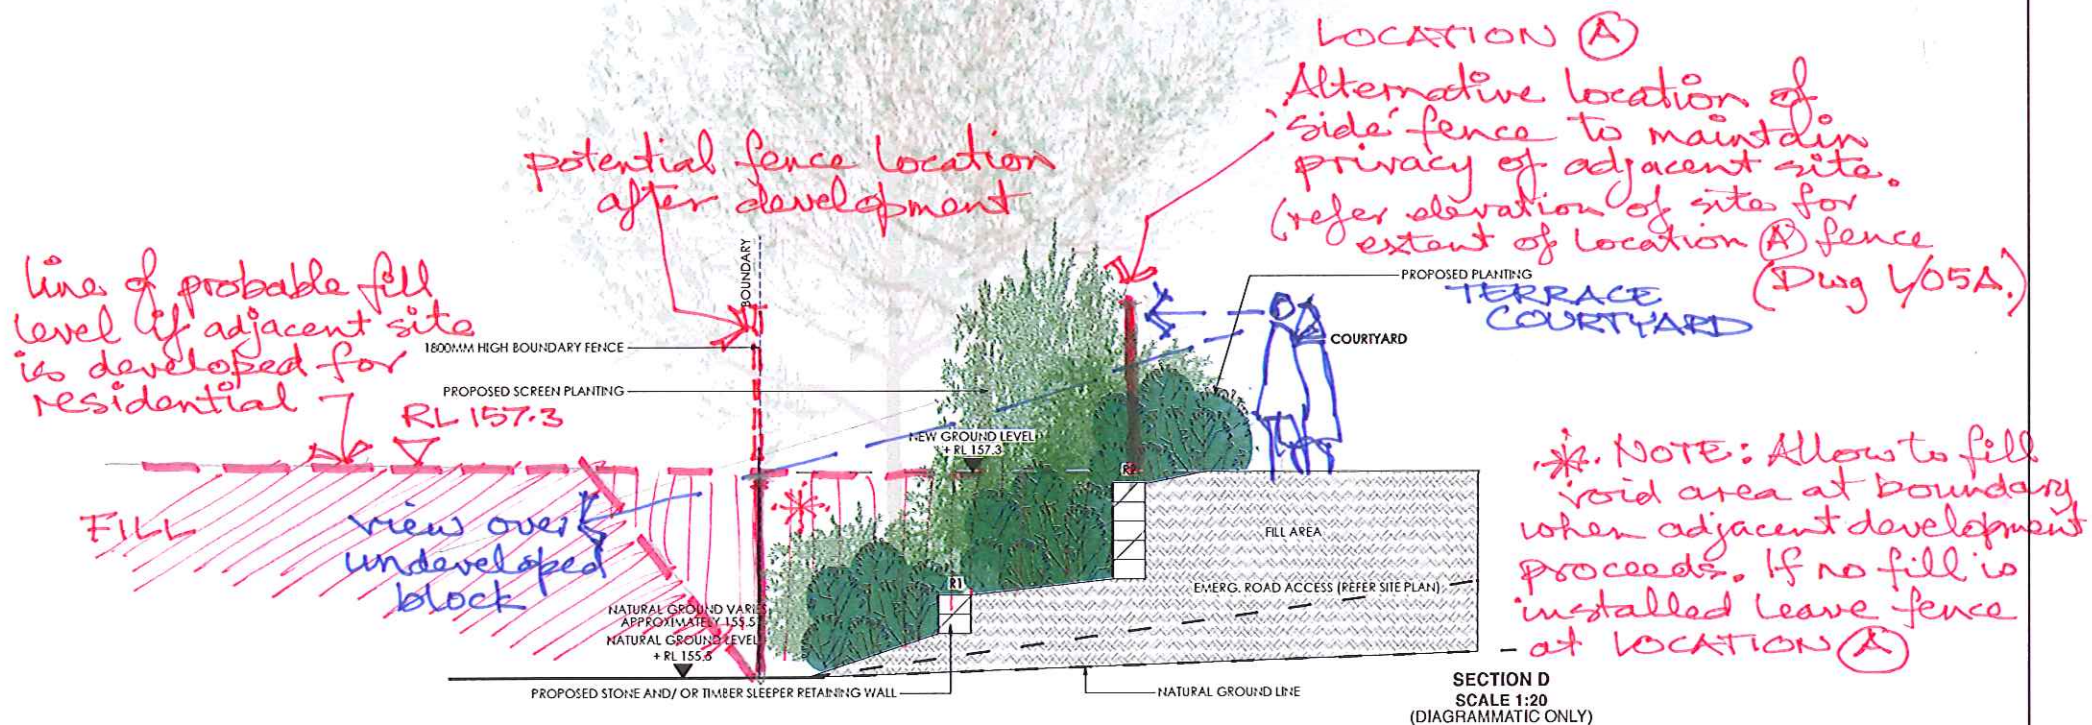

Client	Architect & Designer	Project	Notes	Revision	Description	Date	EXAMPLE: FLOOD RESERVE SECTION DETAILS
CORBETT CONSTRUCTIONS PTY LTD	Woodhouse DANKS DRAKE DESIGNS	PROPOSED RESIDENTIAL DEVELOPMENT	1. All dimensions and levels shall be verified by Contractor on-site prior to commencement of work. 2. Do not scale from drawings. 3. If in doubt contact Landscape Architect. 4. This design is copyright and shall not be copied, utilised or reproduced in any way without prior written permission of A Total Concept Landscape Architects.	A	SECTIONS AS PER COUNCIL REQUIREMENT	26/03/18	91-103 MENANGLE STREET, PICTON A Total Concept Landscape Architects 91-103 Menangle Street, Picton NSW 2572 Tel: 08 8361 1111 Fax: 08 8361 1112 atc A Total Concept Landscape Architects
							SCALE: 1:20 SCALE: 1:20 DRAWN: [Signature] CHECKED: [Signature] PROJECT: [Signature] DATE: 26/03/18