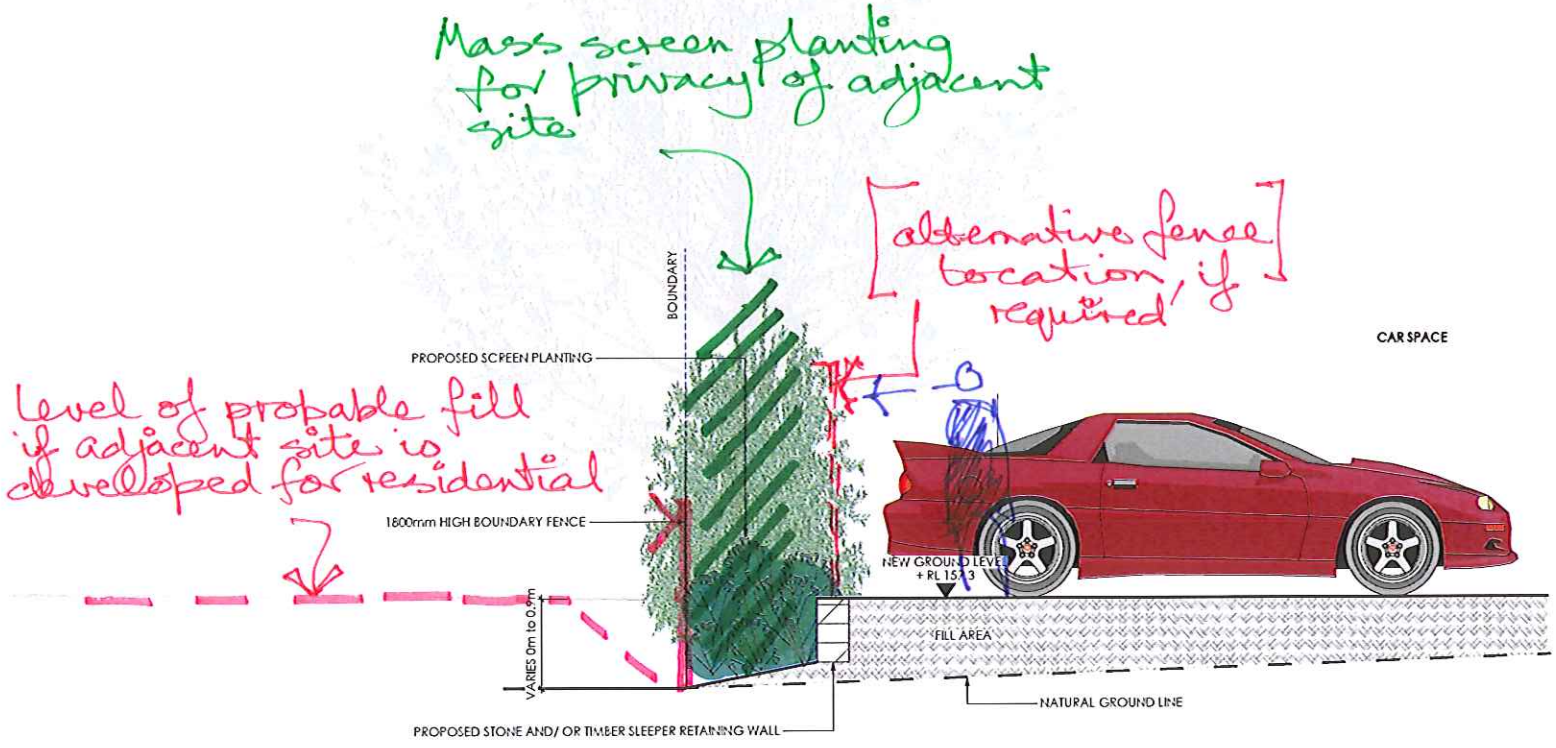

SECTION E
SCALE 1:20
(DIAGRAMMATIC ONLY)

Client	Architect & Designer	Project	Notes
CORBETT CONSTRUCTIONS PTY LTD	Woodhouse DANKS DRAKE DESIGNS	PROPOSED RESIDENTIAL DEVELOPMENT	1. All dimensions and levels shall be verified by Contractor on site prior to commencement of work. 2. Do not scale from drawings. 3. If in doubt contact Landscape Architect. 4. This design is copyright and shall not be copied, utilised or reproduced in any way without prior written permission of A Total Concept Landscape Architects.

Revision	Description	Date
A	SECTIONS AS PER COUNCIL REQUIREMENT	28/03/18

DRAWING: FLOOD RESERVE SECTION DETAILS

ADDRESS: 91-103 MENANGLE STREET, PICTON

A Total Concept Landscape Architects
43 Hunter Street, North Sydney NSW 2060
Tel (02) 9929 4655 Fax (02) 9929 5922
www.atotalconcept.com.au

atc a total concept

SCALE @ A1
SCALE @ A3
DRAWN: RW
CHKD: JB
PROJECT #
DRAWING #: L/07 A